
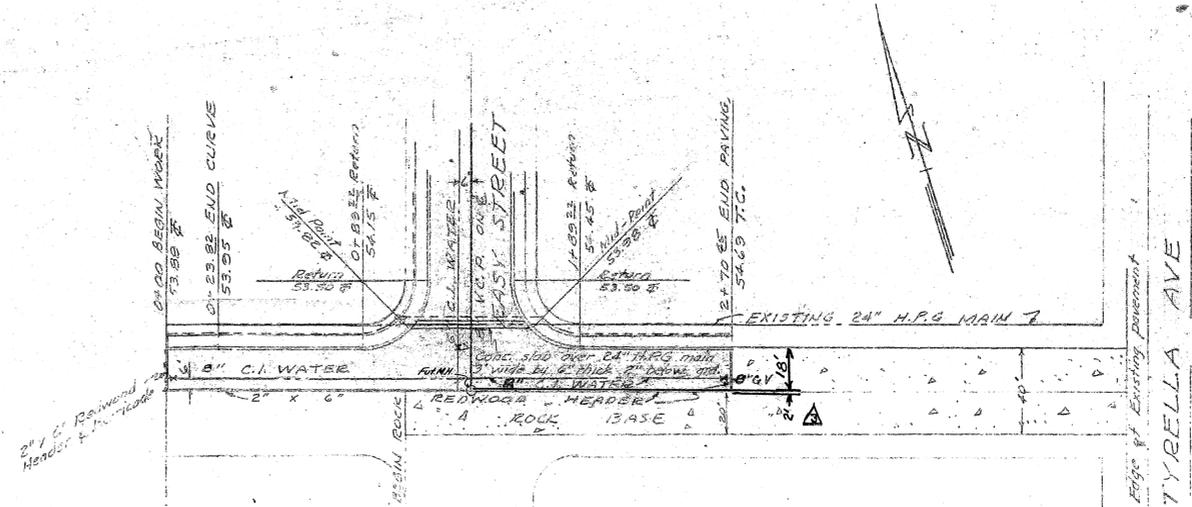



DATUM: City of Mountain View B.M. #152. E1 = 51.775. Spike in pole SW corner Tyrrel Ave & Mountain.

- CONSTRUCTION NOTES:**
1. Install standard city monument (3) as shown on subdwg.
 2. All work and materials to conform to specifications of the City of Mountain View, California.
 3. End of sewer laterals to be at property line side line of.
 4. Water services to be at least 4' distant from sewer service.
 5. Water service for each lot. Water services shall be minimum 1/2 inch.
 6. Contractors and subcontractors are to notify the City of Mountain View, Dept. of Public Works, at least 48 hours before starting.
 7. Street trees to be planted at approximately 50' foot intervals of trees, Schwedler Maple - 1/2 inch of trees.
 8. Cut sheets shall be furnished to the City of Mountain View prior to construction.
 9. Concrete contractor shall mark face of curb with a letter 'L' for lateral locations and a 'W' for water services.
 10. Owner's Engineer shall stake all driveways, sewer laterals, manholes and hydrants for location and grade and shall furnish as built plan.
 11. All concrete emplacement shall be from expansion joint to edge.

- LEGEND**
- 8" Cast iron water line, valve & hydrant, & water service
 - 8" V.C.P. sanitary sewer, manholes & 4" laterals
 - Existing 24" High pressure gas main
 - - - 1 1/2" underground galvanized conduit & cable (except trees)
 - T - Tree

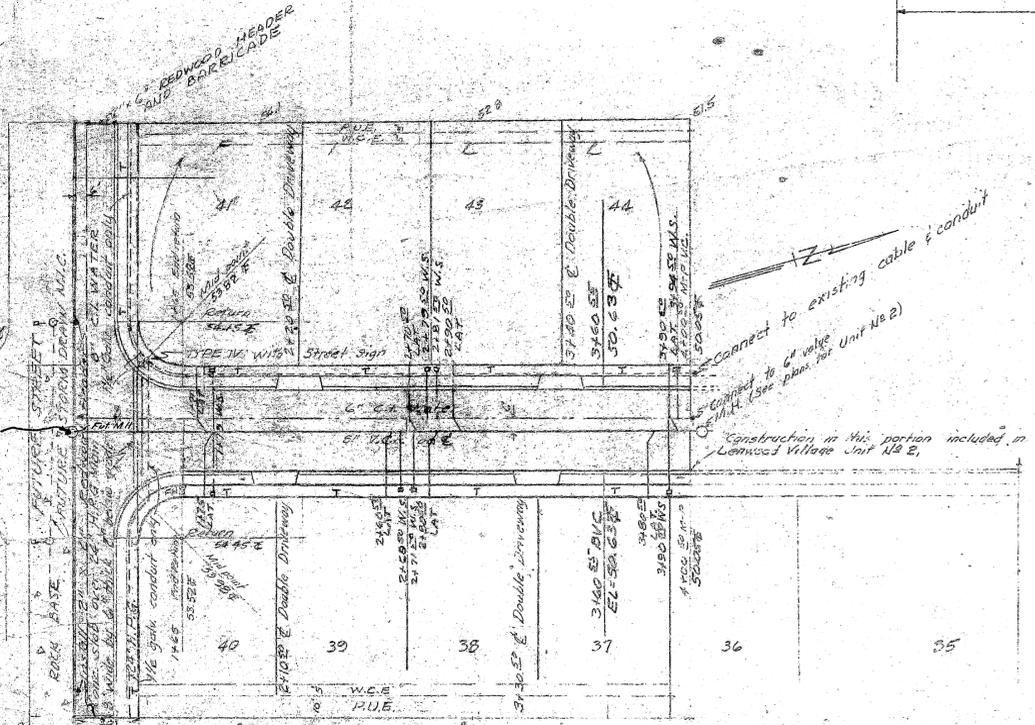

- STREET LIGHTING NOTE:**
- Use 6000 volt cable in 1 1/2 inch galvanized conduit shown on plan as a dashed line. Connect to existing cable and conduit of Sta. 4+01 on west side of Easy Street. Apply and pay for high voltage cut sheet. Supply map to P.G. & E. showing location of underground as actually installed.
 - Electronics to be 4000 lumen multiple initially (future as installed).
 - Dashed line running easterly and westerly along Walker Drive indicates 1 1/2 inch conduit only - no cable.

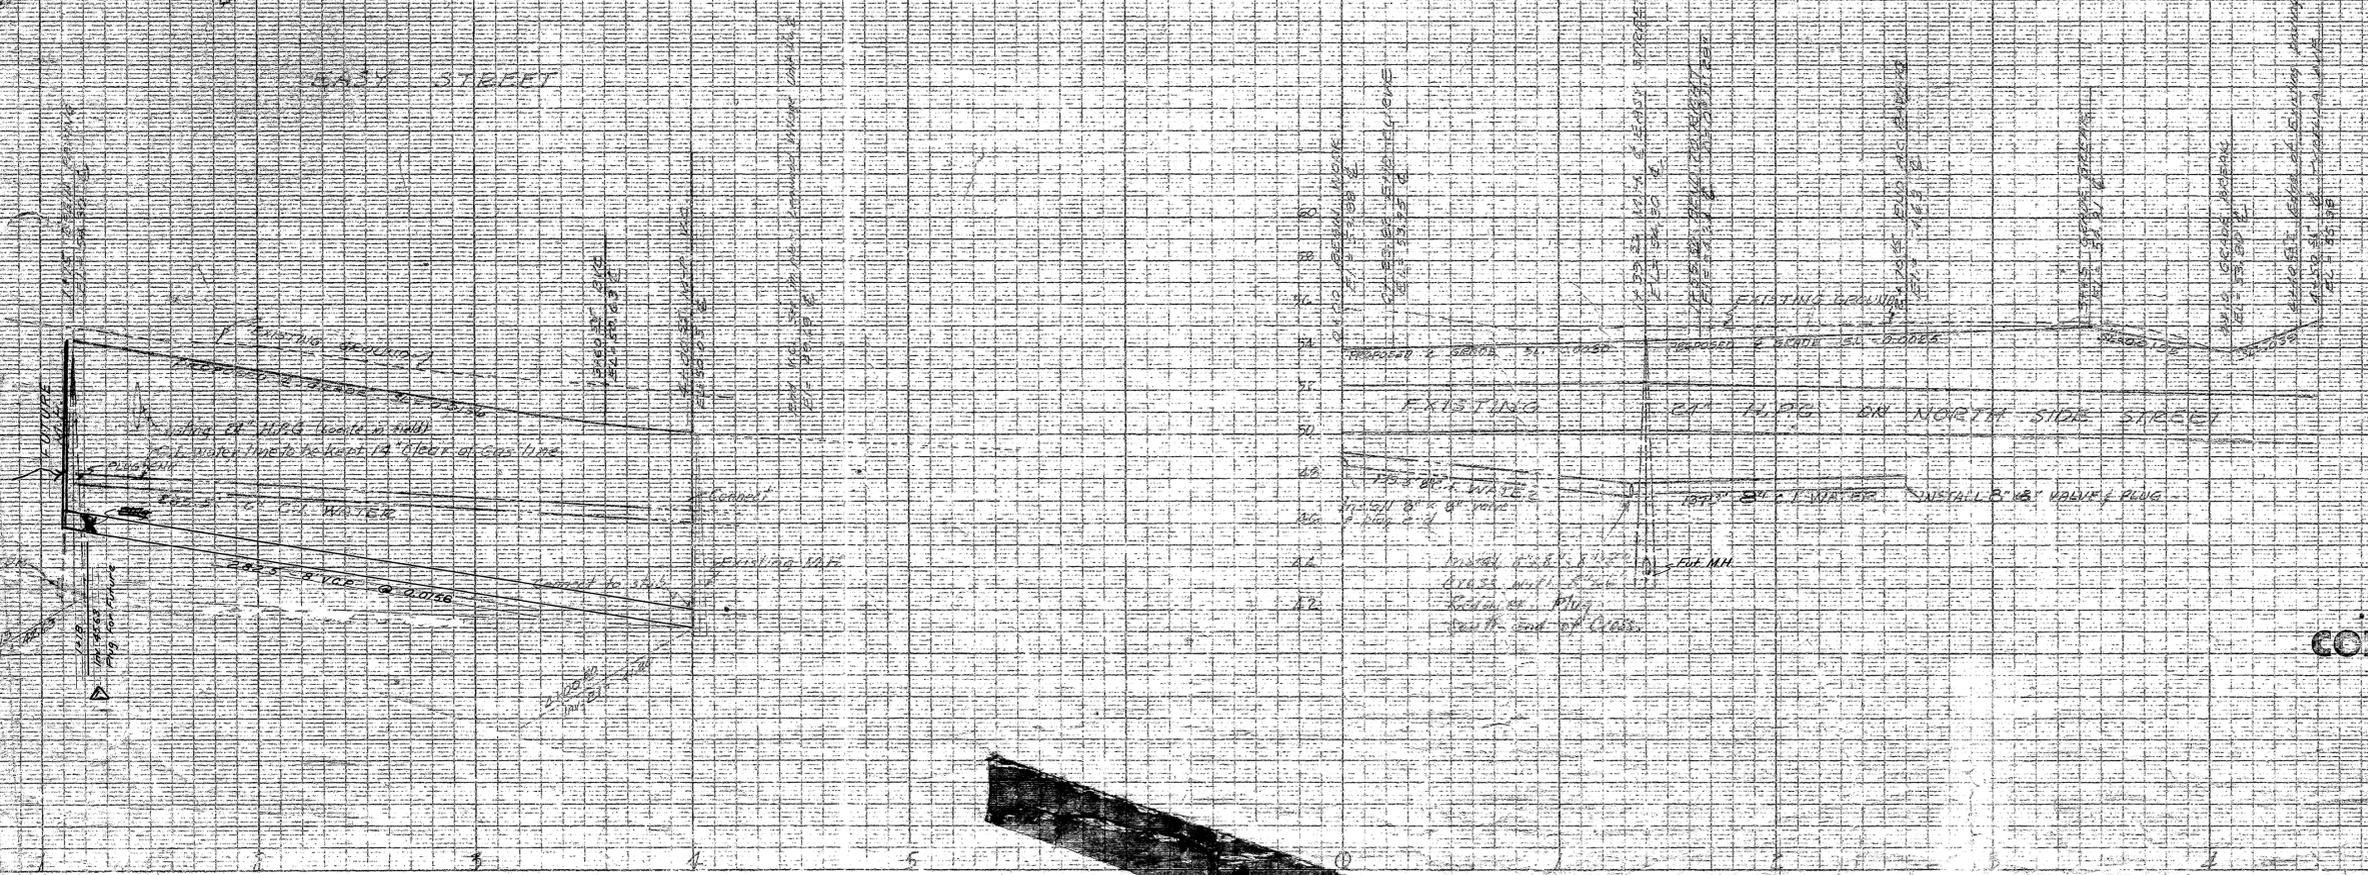

CONTRACT PLAN

MICROFILMED FEB 65

1	WALKER DR PAVING WIDTH	1
2	EASY ST BASE ROCK - 6" x 2" AC	1
NO.	REVISION	
3	EASY ST SANITARY SEWER LOCATION	1

CITY OF MOUNTAIN VIEW
CALIFORNIA
TRACT No. 2142
LENWOOD VILLAGE UNIT No. 1
STREET IMPROVEMENT PLANS

BRANERD BLEHN
REGISTERED CIVIL ENGINEER
LOS ANGELES, CALIFORNIA
APPROVED
8/20/58
1/20/59
Scale 1/4" = 1'-0"
JAN 1959